

ELEVATION CERTIFICATE

Important: Read the instructions on pages 1-9.

OMB No. 1660-0008
 Expiration Date: July 31, 2015

SECTION A - PROPERTY INFORMATION

FOR INSURANCE COMPANY USE

A1. Building Owner's Name Rainier Pacific Bank	Policy Number:
A2. Building Street Address (including Apt., Unit, Suite, and/or Bldg. No.) or P.O. Route and Box No. 1319 Daffodil Ave. N.W.	Company NAIC Number:
City Orting State Wa ZIP Code 98360	

A3. Property Description (Lot and Block Numbers, Tax Parcel Number, Legal Description, etc.)
 Lot 115 of the Plat of Rivers Edge in Orting, Phase 2, TPN 7002121150

A4. Building Use (e.g., Residential, Non-Residential, Addition, Accessory, etc.) Residential

A5. Latitude/Longitude: Lat. 47°07'00.14"N Long. 122°13'18.00"W Horizontal Datum: NAD 1927 NAD 1983

A6. Attach at least 2 photographs of the building if the Certificate is being used to obtain flood insurance.

A7. Building Diagram Number 9

A8. For a building with a crawlspace or enclosure(s):

a) Square footage of crawlspace or enclosure(s)	<u>791</u> sq ft	A9. For a building with an attached garage:	a) Square footage of attached garage	<u>382</u> sq ft
b) Number of permanent flood openings in the crawlspace or enclosure(s) within 1.0 foot above adjacent grade	<u>9</u>		b) Number of permanent flood openings in the attached garage within 1.0 foot above adjacent grade	<u>NA</u>
c) Total net area of flood openings in A8.b	<u>848</u> sq in		c) Total net area of flood openings in A9.b	<u>NA</u> sq in
d) Engineered flood openings?	<input checked="" type="checkbox"/> Yes <input checked="" type="checkbox"/> No		d) Engineered flood openings?	<input type="checkbox"/> Yes <input checked="" type="checkbox"/> No

SECTION B - FLOOD INSURANCE RATE MAP (FIRM) INFORMATION

B1. NFIP Community Name & Community Number Orting Town of 530138	B2. County Name Pierce	B3. State Wa
---	---------------------------	-----------------

B4. Map/Panel Number <u>5301380602</u> <u>530138/0601</u>	B5. Suffix c	B6. FIRM Index Date 8/19/87	B7. FIRM Panel Effective/Revised Date 8/19/87	B8. Flood Zone(s) AE	B9. Base Flood Elevation(s) (Zone AO, use base flood depth) 146.0
---	-----------------	--------------------------------	--	-------------------------	--

B10. Indicate the source of the Base Flood Elevation (BFE) data or base flood depth entered in Item B9.
 FIS Profile FIRM Community Determined Other/Source: _____

B11. Indicate elevation datum used for BFE in Item B9: NGVD 1929 NAVD 1988 Other/Source: _____

B12. Is the building located in a Coastal Barrier Resources System (CBRS) area or Otherwise Protected Area (OPA)? Yes No
 Designation Date: _____ CBRS OPA

SECTION C - BUILDING ELEVATION INFORMATION (SURVEY REQUIRED)

C1. Building elevations are based on: Construction Drawings* Building Under Construction* Finished Construction
 *A new Elevation Certificate will be required when construction of the building is complete.

C2. Elevations - Zones A1-A30, AE, AH, A (with BFE), VE, V1-V30, V (with BFE), AR, AR/A, AR/AE, AR/A1-A30, AR/AH, AR/AO. Complete Items C2.a-h below according to the building diagram specified in Item A7. In Puerto Rico only, enter meters.

Benchmark Utilized: Pierce County #121-32U Vertical Datum: Elevation = 164.20

Indicate elevation datum used for the elevations in items a) through h) below. NGVD 1929 NAVD 1988 Other/Source: _____

Datum used for building elevations must be the same as that used for the BFE.

		Check the measurement used.	
a) Top of bottom floor (including basement, crawlspace, or enclosure floor)	<u>146.6</u>	<input checked="" type="checkbox"/> feet	<input type="checkbox"/> meters
b) Top of the next higher floor	<u>149.6</u>	<input checked="" type="checkbox"/> feet	<input type="checkbox"/> meters
c) Bottom of the lowest horizontal structural member (V Zones only)	<u>NA</u>	<input checked="" type="checkbox"/> feet	<input type="checkbox"/> meters
d) Attached garage (top of slab)	<u>148.1</u>	<input checked="" type="checkbox"/> feet	<input type="checkbox"/> meters
e) Lowest elevation of machinery or equipment servicing the building (Describe type of equipment and location in Comments)	<u>149.4</u>	<input checked="" type="checkbox"/> feet	<input type="checkbox"/> meters
f) Lowest adjacent (finished) grade next to building (LAG)	<u>147.4</u>	<input checked="" type="checkbox"/> feet	<input type="checkbox"/> meters
g) Highest adjacent (finished) grade next to building (HAG)	<u>147.8</u>	<input checked="" type="checkbox"/> feet	<input type="checkbox"/> meters
h) Lowest adjacent grade at lowest elevation of deck or stairs, including structural support	<u>NA</u>	<input checked="" type="checkbox"/> feet	<input type="checkbox"/> meters

SECTION D - SURVEYOR, ENGINEER, OR ARCHITECT CERTIFICATION

This certification is to be signed and sealed by a land surveyor, engineer, or architect authorized by law to certify elevation information. I certify that the information on this Certificate represents my best efforts to interpret the data available. I understand that any false statement may be punishable by fine or imprisonment under 18 U.S. Code, Section 1001.

Check here if comments are provided on back of form. Were latitude and longitude in Section A provided by a licensed land surveyor? Yes No

Check here if attachments.

Surveyor's Name G. Phil Sargent	License Number 34145
Title Owner Company Name Dryco Surveying	
Address 827 Main St. Ste A	City Sumner State Wa ZIP Code 98390
Signature <i>G. Phil Sargent</i>	Date 2/18/13 Telephone 253-826-0300



IMPORTANT: In these spaces, copy the corresponding information from Section A.	FOR INSURANCE COMPANY USE
Building Street Address (including Apt., Unit, Suite, and/or Bldg. No.) or P.O. Route and Box No. 1319 Daffodil Ave. N.W.	Policy Number:
City Orting State Wa ZIP Code 98360	Company NAIC Number:

SECTION D – SURVEYOR, ENGINEER, OR ARCHITECT CERTIFICATION (CONTINUED)

Copy both sides of this Elevation Certificate for (1) community official, (2) insurance agent/company, and (3) building owner.

Comments Lowest machinery is the hot water tank located in the garage.

Phil Syant
Signature

Date 2/18/13

SECTION E – BUILDING ELEVATION INFORMATION (SURVEY NOT REQUIRED) FOR ZONE AO AND ZONE A (WITHOUT BFE)

For Zones AO and A (without BFE), complete Items E1–E5. If the Certificate is intended to support a LOMA or LOMR-F request, complete Sections A, B, and C. For Items E1–E4, use natural grade, if available. Check the measurement used. In Puerto Rico only, enter meters.

- E1. Provide elevation information for the following and check the appropriate boxes to show whether the elevation is above or below the highest adjacent grade (HAG) and the lowest adjacent grade (LAG).
 - a) Top of bottom floor (including basement, crawlspace, or enclosure) is _____ feet meters above or below the HAG.
 - b) Top of bottom floor (including basement, crawlspace, or enclosure) is _____ feet meters above or below the LAG.
- E2. For Building Diagrams 6–9 with permanent flood openings provided in Section A Items 8 and/or 9 (see pages 8–9 of Instructions), the next higher floor (elevation C2.b in the diagrams) of the building is _____ feet meters above or below the HAG.
- E3. Attached garage (top of slab) is _____ feet meters above or below the HAG.
- E4. Top of platform of machinery and/or equipment servicing the building is _____ feet meters above or below the HAG.
- E5. Zone AO only: If no flood depth number is available, is the top of the bottom floor elevated in accordance with the community's floodplain management ordinance? Yes No Unknown. The local official must certify this information in Section G.

SECTION F – PROPERTY OWNER (OR OWNER'S REPRESENTATIVE) CERTIFICATION

The property owner or owner's authorized representative who completes Sections A, B, and E for Zone A (without a FEMA-issued or community-issued BFE) or Zone AO must sign here. The statements in Sections A, B, and E are correct to the best of my knowledge.

Property Owner's or Owner's Authorized Representative's Name _____

Address _____	City _____	State _____	ZIP Code _____
Signature _____	Date _____	Telephone _____	

Comments _____

Check here if attachments.

SECTION G – COMMUNITY INFORMATION (OPTIONAL)

The local official who is authorized by law or ordinance to administer the community's floodplain management ordinance can complete Sections A, B, C (or E), and G of this Elevation Certificate. Complete the applicable item(s) and sign below. Check the measurement used in Items G8–G10. In Puerto Rico only, enter meters.

- G1. The information in Section C was taken from other documentation that has been signed and sealed by a licensed surveyor, engineer, or architect who is authorized by law to certify elevation information. (Indicate the source and date of the elevation data in the Comments area below.)
- G2. A community official completed Section E for a building located in Zone A (without a FEMA-issued or community-issued BFE) or Zone AO.
- G3. The following information (Items G4–G10) is provided for community floodplain management purposes.

G4. Permit Number <i>1-2943</i>	G5. Date Permit Issued <i>10-18-12</i>	G6. Date Certificate Of Compliance/Occupancy Issued <i>2-2-13</i>
------------------------------------	---	--

- 37. This permit has been issued for: New Construction Substantial Improvement
- 38. Elevation of as-built lowest floor (including basement) of the building: _____ feet meters Datum _____
- 39. BFE or (in Zone AO) depth of flooding at the building site: _____ feet meters Datum _____
- 310. Community's design flood elevation: _____ feet meters Datum _____

Local Official's Name <i>Ken Wolfe</i>	Title <i>Bldg Official</i>
Community Name <i>City of Orting</i>	Telephone <i>360 893 2219</i>
Signature <i>Ken Wolfe</i>	Date <i>11-2-16</i>

Comments *City noted missing info on A8d, A9d & B4* Check here if attachments.


SITE & STORM LEGEND:

Ⓞ Area to be amended top-soiled, seeded & mulched by owner at the completion of construction.

Ⓞ Temp. Const. Entrance (if driveway not installed) See Detail attached

○ Silt Fence

↘ General Surface Drainage

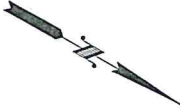


Minimum Finish Floor
Elev. 146'

IMPERVIOUS SURFACE:
Roof: 1,508 sq. ft.
Driveway/Flatwork: 466 sq.ft.
Lot: 7,260
27.2% Lot Coverage

DIMENSIONS LEGEND:

A: Wall to Wall
B: Overhang to Overhang (12" typical)
C: Gutter to Gutter (4" typical)

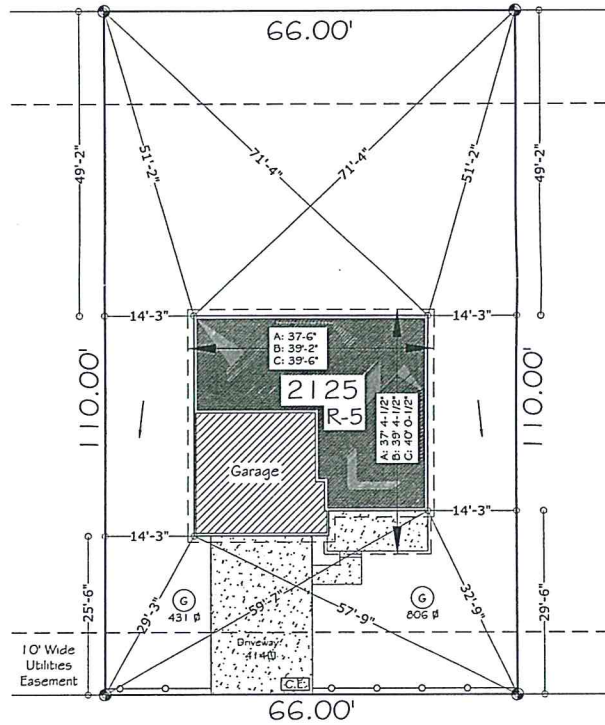

ADDRESS: 1319 Daffodil Ave. NE		THE PEOPLES BUILDER L.L.C. 1125 57TH ST. E. Suite D Sumner, WA 98093 253.405.2592	Rivers Edge LOT 115
PARCEL NUMBER: 7002121150			
DATE: 8-31-12	Scale: 1:20		

APPROVED
MATERIAL & CONSTRUCTION
SUBJECT TO IBC, IRC, UPC & IMC 2009
EDITION & AMENDMENTS
DATE 10-10-2012
BY *[Signature]*
BUILDING DEPARTMENT
CITY OF ORTING

City of Orting
Coded
2710

issued 10/13/12

FILE COPY

✓

F 2.7.13



City of Orting Floodplain Development Permit

Permit No. 1-2943

Has been issued to Seawest Investment Assoc. LLC
(Taloma Peoples Builder)

For construction of New Single Family Residence

At 1319 Daffodil Ave NE


Parcel # 7002121150 Lot 115 Subdivision River's Edge

SHORELINE REVIEW:

BA (Biological Assessment)

BE (Biological Evaluation)

City of Orting, Washington

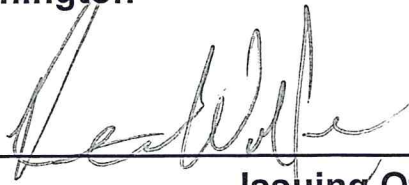

Issuing Officer

This notice shall be posted in a conspicuous location at the front of the above described property at the time of commencement of work.